

**1. CRD PREPARING PROFESSIONAL:** MY FIRM MEASURED THE AS-INSTALLED LOCATIONS AND ELEVATIONS OF THAT PORTION OF THE IMPROVEMENTS WHICH CAN BE MEASURED FROM THE SURFACE AND THAT THOSE MEASUREMENTS:

**A. WERE TAKEN IN THE MANNER AND TO THE ACCURACY SET FORTH IN THE PUBLIC FACILITIES MANUAL, AND,**

**B. HAVE BEEN INDICATED ON THE FOLLOWING SHEETS ACCURATELY AND IN THE MANNER WHICH DISTINGUISHES THIS AS-INSTALLED INFORMATION FROM THE AS-DESIGNED INFORMATION, AND THAT,**

**C. ANY ADDITIONAL INFORMATION FURNISHED BY THE CITY HAS BEEN ACCURATELY TRANSCRIBED ONTO THESE CRD'S.**


FIRM NAME: \_\_\_\_\_

NAME, TITLE, LICENSE TYPE, AND NUMBER: \_\_\_\_\_

SIGNATURE AND DATE: \_\_\_\_\_

HYDRANT INFORMATION	
HYDRANT	G
SIZE	4 1/2"
OPEN DIRECTION	
TURNS	
COVER	
DATE	2004
MANUFACTURER	MUELLER

VALVE INFORMATION									
VALVE	A	B	C	D	E	F	G	BOV 1	BOV 2
SIZE	8"	8"	4"	8"	8"	8"	6"	2"	2"
JOINT TYPE	MJ								
OPEN DIRECTION									
TURNS									
COVER									
DATE	2005	2005	2005	2005	2005	2005	2004	2005	2005
MANUFACTURER	MUELLER								

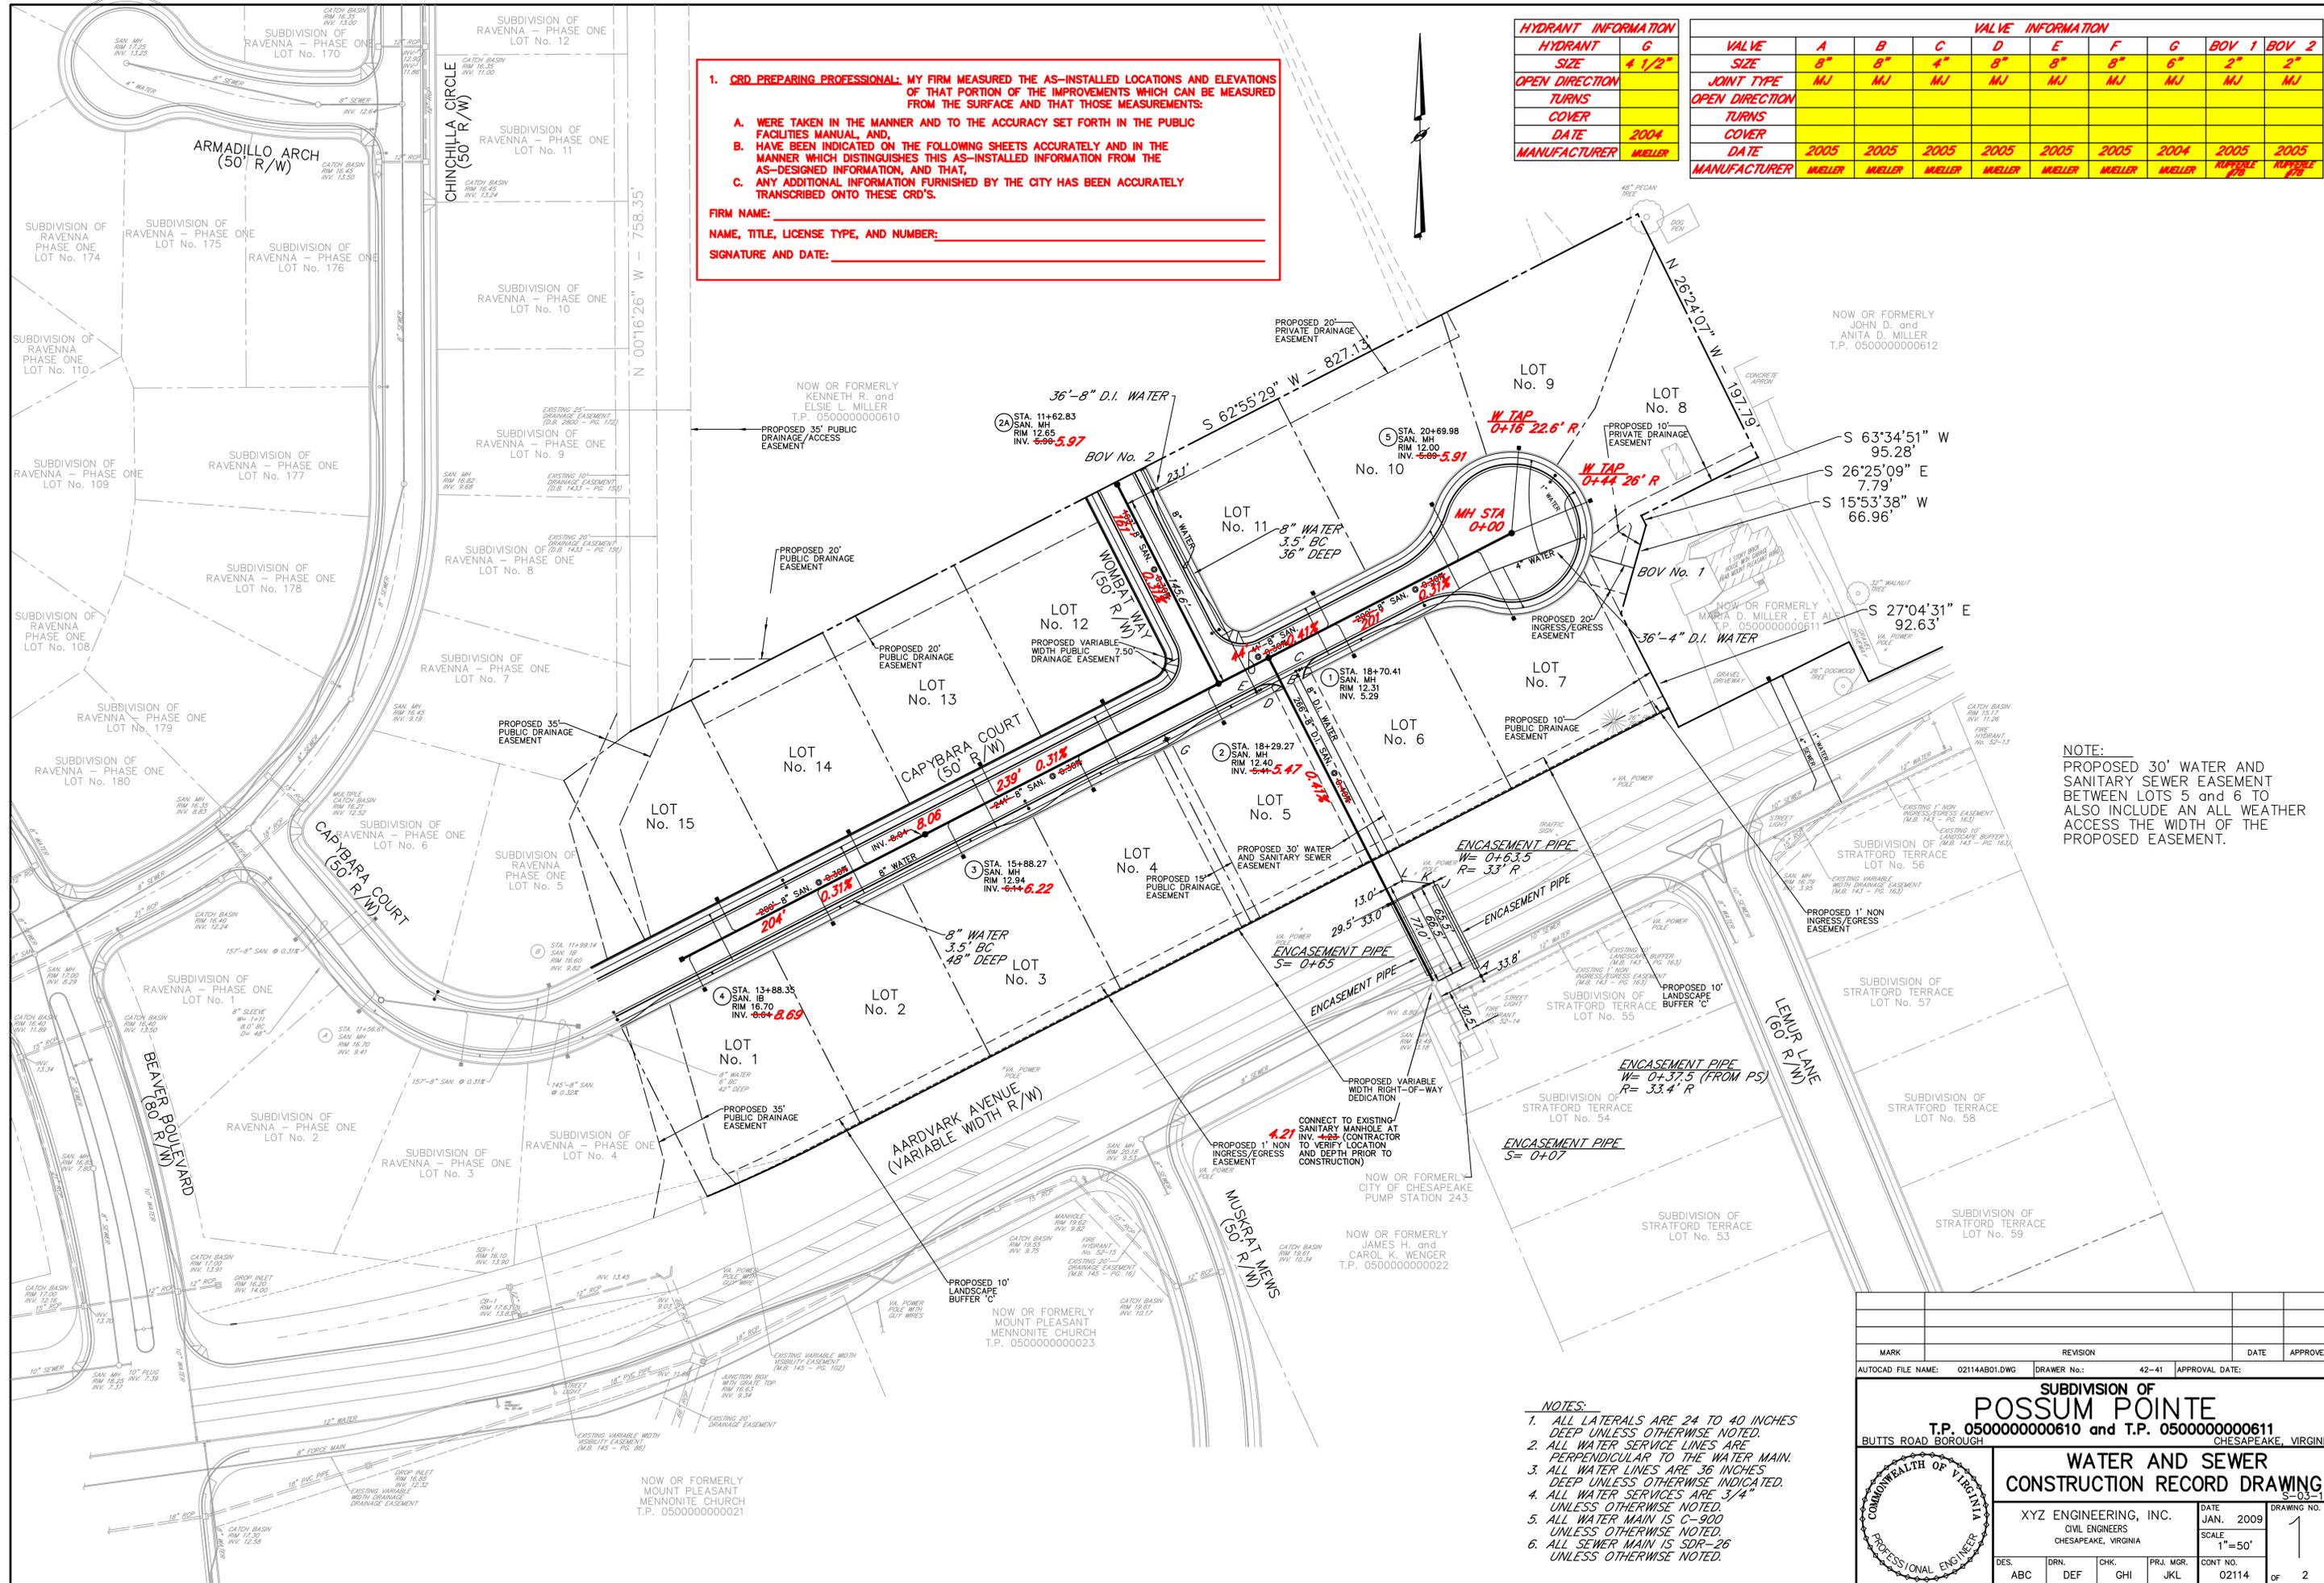

NOTE:  
 PROPOSED 30' WATER AND SANITARY SEWER EASEMENT BETWEEN LOTS 5 and 6 TO ALSO INCLUDE AN ALL WEATHER ACCESS THE WIDTH OF THE PROPOSED EASEMENT.

- NOTES:**
- ALL LATERALS ARE 24 TO 40 INCHES DEEP UNLESS OTHERWISE NOTED.
  - ALL WATER SERVICE LINES ARE PERPENDICULAR TO THE WATER MAIN.
  - ALL WATER LINES ARE 36 INCHES DEEP UNLESS OTHERWISE INDICATED.
  - ALL WATER SERVICES ARE 3/4" UNLESS OTHERWISE NOTED.
  - ALL WATER MAIN IS C-900 UNLESS OTHERWISE NOTED.
  - ALL SEWER MAIN IS SDR-26 UNLESS OTHERWISE NOTED.

MARK	REVISION	DATE	APPROVED
AUTOCAD FILE NAME: 02114A01.DWG	DRAWER No.: 42-41	APPROVAL DATE:	
<b>SUBDIVISION OF POSSUM POINTE</b>			
T.P. 050000000610 and T.P. 050000000611			
BUTTS ROAD BOROUGH, CHESAPEAKE, VIRGINIA			
<b>WATER AND SEWER CONSTRUCTION RECORD DRAWING</b>			
XYZ ENGINEERING, INC. CIVIL ENGINEERS CHESAPEAKE, VIRGINIA			DATE JAN. 2009 SCALE 1"=50'
DES. ABC	DRN. DEF	CHK. GHI	PRJ. MGR. JKLM
CONT NO. 02114			DRAWING NO. 1 OF 2

