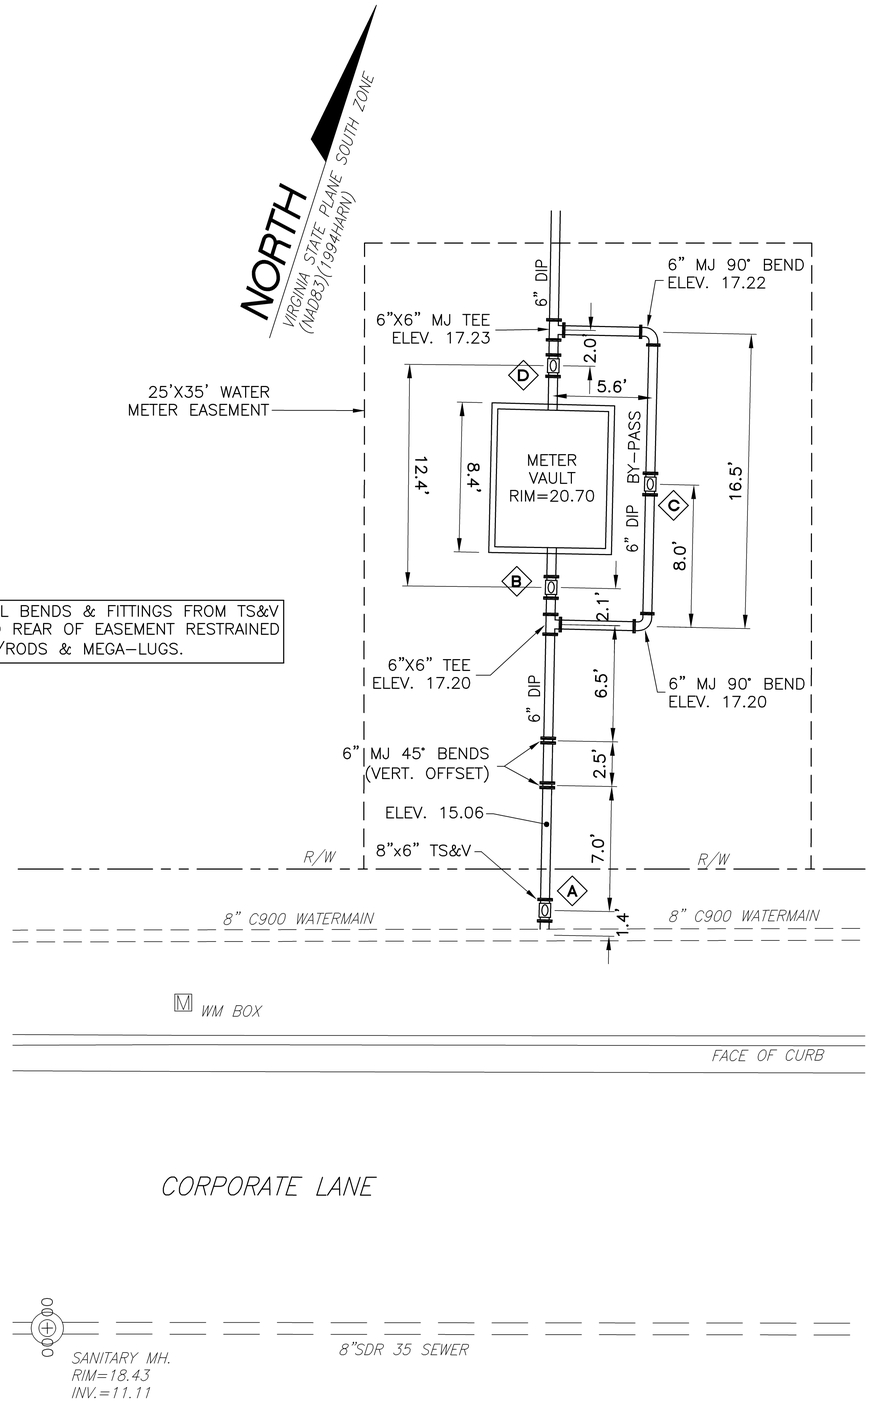

ALL BENDS & FITTINGS FROM TS&V TO REAR OF EASEMENT RESTRAINED W/RODS & MEGA-LUGS.

WATER VALVE & HYDRANT CHART

NO.	SIZE	MANUFACTURER VALVE & DATE	DATE SET	NO. OF TURNS	COVER	OPEN	JOINT TYPE	ELEV. OF OPERATING NUT	GRID COORDINATES	STATIONING
A	6"	AFC (TV) 2014	1/15/15	20-3/4	2.77'	RIGHT	FLGxMJ	16.18	N 3443749.2574 E 12147867.8561	0+27.5 RU 23'
B	6"	AFC (GV) 2014	1/16/15	20-3/4	2.15'	RIGHT	MJxMJ	18.32	N 3443766.5569 E 12147862.6730	0+27.5 RU 41'
C	6"	AFC (GV) 2014	1/16/15	20-3/4	2.23'	RIGHT	MJxMJ	18.32	N 3443773.7470 E 12147866.1819	0+33.7 RU 47'
D	6"	AFC (GV) 2014	1/16/15	20-3/4	2.30'	RIGHT	MJxMJ	18.35	N 3443778.3964 E 12147858.9980	0+27.5 RU 54'

CONSTRUCTION RECORD DRAWING (CRD) PREPARING PROFESSIONAL.

MY FIRM MEASURED THE AS-INSTALLED LOCATIONS AND ELEVATIONS OF THAT PORTION OF THE IMPROVEMENTS WHICH CAN BE MEASURED FROM THE SURFACE AND THAT THOSE MEASUREMENTS:

A. WERE TAKEN IN THE MANNER AND TO THE ACCURACY SET FORTH IN THE PUBLIC FACILITIES MANUAL, AND

B. HAVE BEEN INDICATED ON THE FOLLOWING SHEETS ACCURATELY AND IN THE MANNER WHICH DISTINGUISHES THIS AS-BUILT INFORMATION FROM THE AS-DESIGNED INFORMATION AND THAT

C. ANY ADDITIONAL INFORMATION FURNISHED BY THE CITY HAS BEEN ACCURATELY TRANSCRIBED ONTO THESE CRD'S.

FIRM NAME: _____

NAME, TITLE LICENSE TYPE AND NUMBER: _____
TITLE
LIC. NO.

4 2 0 4 8
scale feet

No.	DATE	DESCRIPTION	BY
		REVISIONS	

APPROVAL DATE:

METER VAULT AS-BUILT
FOR
904 CORPORATE LANE
WASHINGTON BOROUGH, CHESAPEAKE, VIRGINIA
TAX MAP NUMBER: 037301000040

DATE: 1/27/15
SCALE: 1"=4'
ENGR.:
DESIGN:
DRAWN:

SHEET NO.
1
1 OF 1

CAD FILE:
PROJ No: